



MIAMI-DADE COUNTY
DEPARTMENT OF PERMITTING, ENVIRONMENT, AND REGULATORY
AFFAIRS (PERA)
BOARD AND CODE ADMINISTRATION DIVISION
NOTICE OF ACCEPTANCE (NOA)

MIAMI-DADE COUNTY
PRODUCT CONTROL SECTION
11805 SW 26 Street, Room 208
Miami, Florida 33175-2474
T (786) 315-2590 F (786) 315-2599
www.miamidade.gov/pera/

T.M. Windows, L.L.C.
601 N.W. 12th Ave.
Pompano Beach, FL 33069

SCOPE:

This NOA is being issued under the applicable rules and regulations governing the use of construction materials. The documentation submitted has been reviewed and accepted by Miami-Dade County PERA -Product Control Section to be used in Miami Dade County and other areas where allowed by the Authority Having Jurisdiction (AHJ).

This NOA shall not be valid after the expiration date stated below. The Miami-Dade County Product Control Section (In Miami Dade County) and/or the AHJ (in areas other than Miami Dade County) reserve the right to have this product or material tested for quality assurance purposes. If this product or material fails to perform in the accepted manner, the manufacturer will incur the expense of such testing and the AHJ may immediately revoke, modify, or suspend the use of such product or material within their jurisdiction. PERA reserves the right to revoke this acceptance, if it is determined by Miami-Dade County Product Control Section that this product or material fails to meet the requirements of the applicable building code.

This product is approved as described herein, and has been designed to comply with the Florida Building Code, including the High Velocity Hurricane Zone.

DESCRIPTION: Series 370 Aluminum Sliding Glass Door w/ reinforcements-Impact

APPROVAL DOCUMENT: Drawing No. **W03-90 Rev E**, titled "Series-370 Alum Sliding Door (L.M.I.)", sheets 1 through 7 of 7, prepared by Al Farooq Corporation, dated 10/06/03 and last revised on May 31, 2012, signed and sealed by Javad Ahmad, P.E., bearing the Miami-Dade County Product Control Revision stamp with the Notice of Acceptance number and expiration date by the Miami-Dade County Product Control Section.

MISSILE IMPACT RATING: Large and Small Missile Impact Resistant

Limitations:

1. Min 3 ksi concrete required at head & sill.
2. Pockets are under separate approval to be reviewed by Bldg official.
3. Max shim not to exceed 1/4", at sill to be filled w/high strength poured & hardened grout.

LABELING: Each unit shall bear a permanent label with the manufacturer's name or logo, city, state and series and following statement: "Miami-Dade County Product Control Approved", noted herein.

RENEWAL of this NOA shall be considered after a renewal application has been filed and there has been no change in the applicable building code negatively affecting the performance of this product.

TERMINATION of this NOA will occur after the expiration date or if there has been a revision or change in the materials, use, and/or manufacture of the product or process. Misuse of this NOA as an endorsement of any product, for sales, advertising or any other purposes shall automatically terminate this NOA. Failure to comply with any section of this NOA shall be cause for termination and removal of NOA.

ADVERTISEMENT: The NOA number preceded by the words Miami-Dade County, Florida, and followed by the expiration date may be displayed in advertising literature. If any portion of the NOA is displayed, then it shall be done in its entirety.

INSPECTION: A copy of this entire NOA shall be provided to the user by the manufacturer or its distributors and shall be available for inspection at the job site at the request of the Building Official.

This NOA **revises** NOA # **09-0319.06** and consists of this page 1 and evidence pages E-1, as well as approval document mentioned above.

The submitted documentation was reviewed by **Ishaq I. Chanda, P.E.**

MIAMI-DADE COUNTY
APPROVED

NOA No 12-0403.03
Expiration Date: March 18, 2014
Approval Date: June 07, 2012
Page 1

5/31/12

NOTICE OF ACCEPTANCE: EVIDENCE SUBMITTED

A. DRAWINGS

1. Manufacturer's die drawings and sections (Submitted under file # **09-0319.06**)
2. Drawing No. **W03-90 Rev E**, titled "Series-370 Alum Sliding Door (L.M.I.)", sheets 1 through 7 of 7, prepared by Al Farooq Corporation, dated 10/06/03 and last revised on May 31, 2012, signed and sealed by Javad Ahmad, P.E.

B. TESTS (submitted under file # **09-0319.06)**

1. Test reports on
 - 1) Air Infiltration Test, per TAS 202-94
 - 2) Uniform Static Air Pressure Test, Loading per TAS 202-94
 - 3) Water Resistance Test, per TAS 202-94.
 - 4) Forced Entry Test per FBC 2411.3.2.1 and TAS202-94.
 - 5) Large Missile Impact Test, per TAS 201-94
 - 6) Cyclic Wind Pressure Loading, per TAS 203-94

Along with marked-up drawings and installation diagram of an aluminum sliding glass door, prepared by Fenestration Testing Laboratories, Test Report No. **FTL-3773**

(FTL03062), dated August 04, 2003, signed and sealed by Joseph Chan, P.E.

Note: This report has been revised by an addendum letter dated January 26, 2004, issued by Fenestration Testing laboratory, signed and sealed by Edmundo Largaespada, P. E. based on the review of the test report.

C. CALCULATIONS

1. Anchor verification calculations and structural analysis, complying with FBC-2010, prepared by Al Farooq Corporation, dated 03/23/12 and last revised on 05/31/12, signed and sealed by Javad Ahmad, P.E.
2. Glazing complies w/ ASTM-E-1300-02 & -04

D. QUALITY ASSURANCE

1. Miami Dade Department of Permitting, Environment, and Regulatory Affairs (PERA).

E. MATERIAL CERTIFICATIONS

1. Notice of Acceptance No. **11-0325.05** for "Saflex clear & color interlayer" issued to Solutia Inc., expiring on 05/21/16.
2. Notice of Acceptance No. **12-0130.01** for "Uvekoll-S laminated glass interlayer", issued to Cytec Industries Inc., expiring on 02-08-2014.

F. STATEMENTS

1. Statement letter of conformance to FBC 2010 and letter of no financial interest, prepared by Al Farooq Corporation, dated 03/21/12, signed and sealed by Javad Ahmad, P.E.
2. Statement letter of conformance FBC 2007 and letter of no financial interest, prepared by Al Farooq Corporation, dated 03/10/09, both signed and sealed by late Humayoun Farooq, P.E. (submitted under file # **09-0319.06**)
3. Addendum letter to test report FTL-3773, dated Jan 26, 2004, issued by Fenestration Testing laboratory, signed & sealed by Edmundo Largaespada, P. E.
4. Lab compliance as part of the above referenced test report.

G. OTHER

1. This NOA revises NOA # **09-0319.06**, expiring on 03/18/14.


Ishaq I. Chanda

Ishaq I. Chanda, P.E.
Product Control Examiner

NOA No 12-0403.03

Expiration Date: March 18, 2014

Approval Date: June 07, 2012

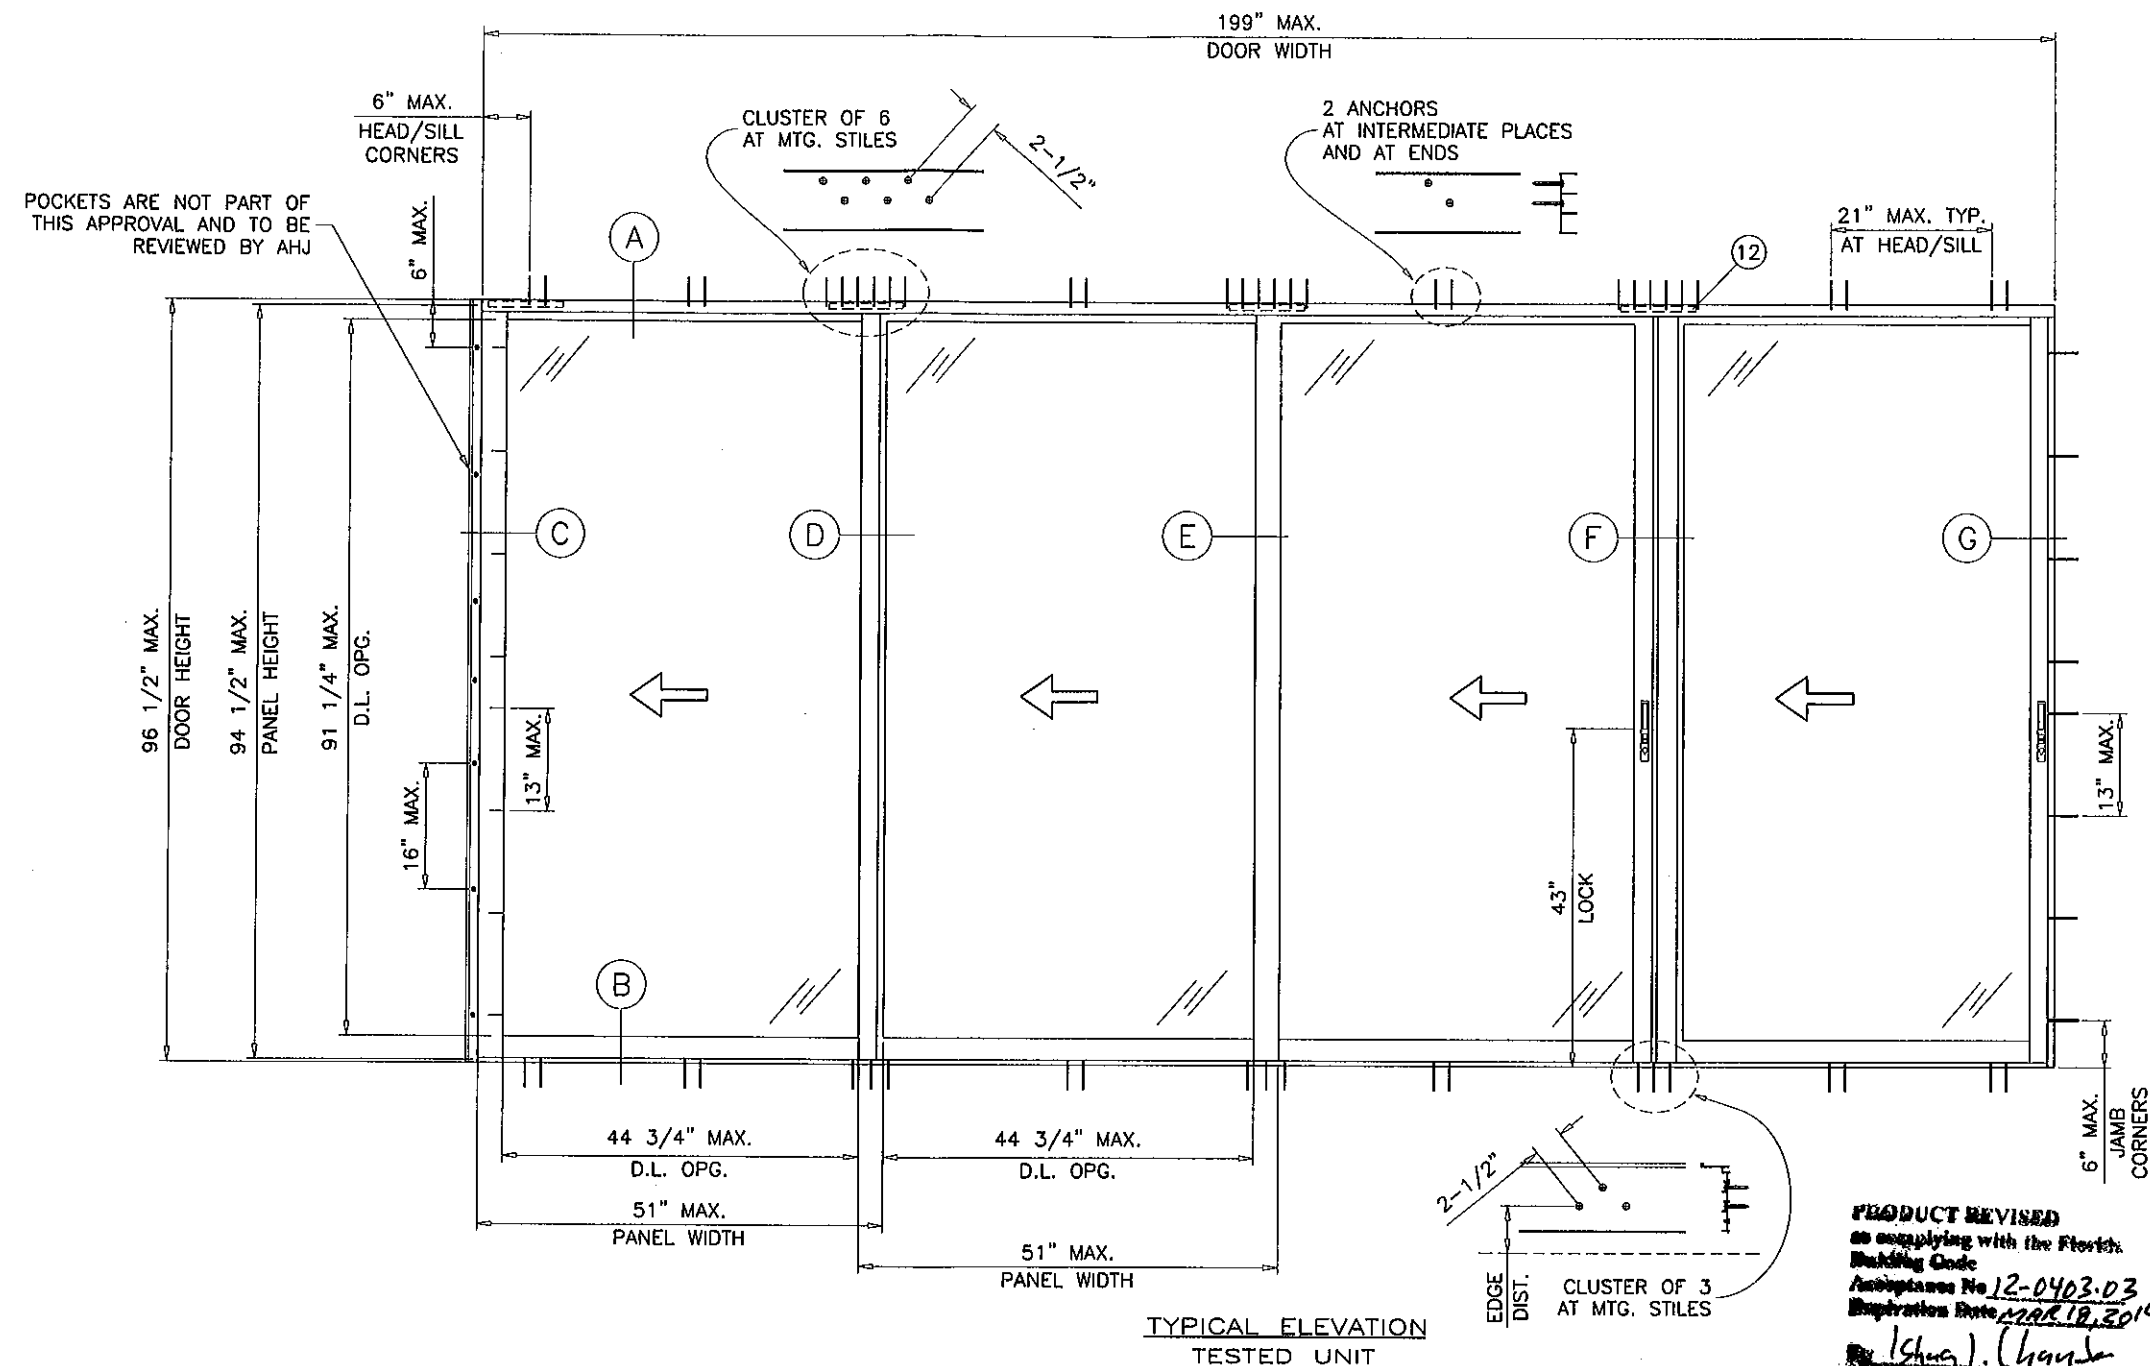

TYPICAL ELEVATION
TESTED UNIT

PRODUCT REVISED
as complying with the Florida
Building Code
Acceptance No 12-0403.03
Expiration Date MAR 18, 2014
(Signature)
Product Control

SERIES-370 ALUM. SLIDING GLASS DOOR (L.M.I.)

DESIGN LOAD RATING FOR THESE DOORS TO BE AS PER CHART
SHOWN ON SHEET 2

THIS PRODUCT HAS BEEN DESIGNED AND TESTED TO COMPLY WITH THE
REQUIREMENTS OF THE FLORIDA BUILDING CODE INCLUDING HIGH VELOCITY
HURRICANE ZONE (HVHZ).

WOOD BUCKS BY OTHERS, MUST BE ANCHORED PROPERLY TO TRANSFER
LOADS TO THE STRUCTURE.

ANCHORS SHALL BE AS LISTED, SPACED AS SHOWN ON DETAILS, ANCHORS
EMBEDMENT TO BASE MATERIAL SHALL BE BEYOND WALL DRESSING OR STUCCO.

ANCHORING OR LOADING CONDITIONS NOT SHOWN IN THESE DETAILS ARE
NOT PART OF THIS APPROVAL.

A LOAD DURATION INCREASE IS USED IN DESIGN OF ANCHORS INTO WOOD ONLY.

MATERIALS INCLUDING BUT NOT LIMITED TO STEEL/METAL SCREWS, THAT
COME INTO CONTACT WITH OTHER DISSIMILAR MATERIALS SHALL MEET THE
REQUIREMENTS OF THE FLORIDA BLDG. CODE SECTION 2003.8.4.

THESE DOORS ARE RATED FOR LARGE AND SMALL MISSILE IMPACT
AND REQUIRE NO SHUTTERS.

Engr: JAVAD AHMAD
CIVIL
FLA. PE # 70592
C.A.N. 3538

MAY 31 2012

af c
AL-FAROOQ CORPORATION
ENGINEERS & PRODUCT DEVELOPMENT
1235 S.W. 87 AVE
MIAMI, FLORIDA 33174
TEL. (305) 264-8100 FAX. (305) 262-6978
COMP-ANL\W03-90TMM






SERIES-370 ALUM. SLIDING GLASS DOOR (L.M.I.)
T.M. WINDOWS LLC.
601 N.W. 12TH AVE.
POMPANO BEACH, FL. 33069
TEL. (954) 781-4430 FAX. (954) 781-5078

no	date	by	description
A	01.27.04	REV. PER BCCO COMMENTS	
B	03.02.04	REV. PER BCCO COMMENTS	
C	10.12.05	UPDATED FOR 2004 FBC	
D	03.06.09	UPDATED FOR 2007 FBC	
E	03.23.12	UPDATED TO 2010 FBC	

date: 10-06-03
scale: 1/2"=1'-0"
dr. by: HAMID
chk. by:

drawing no.
W03-90

sheet 1 of 7

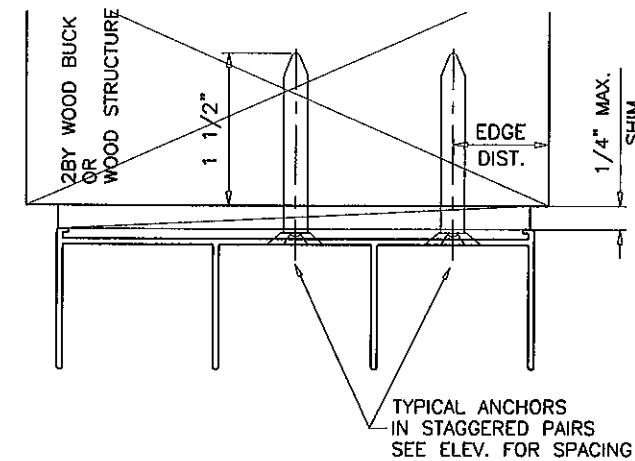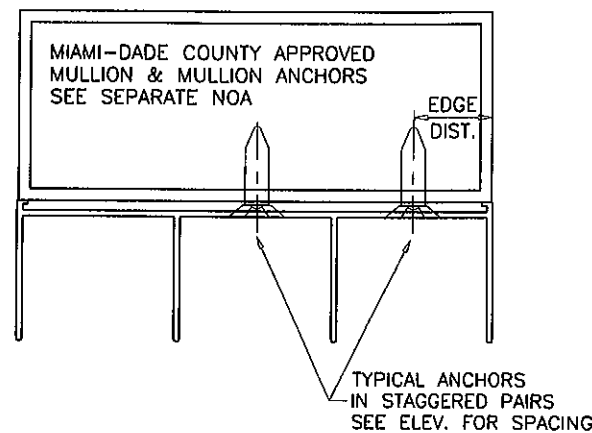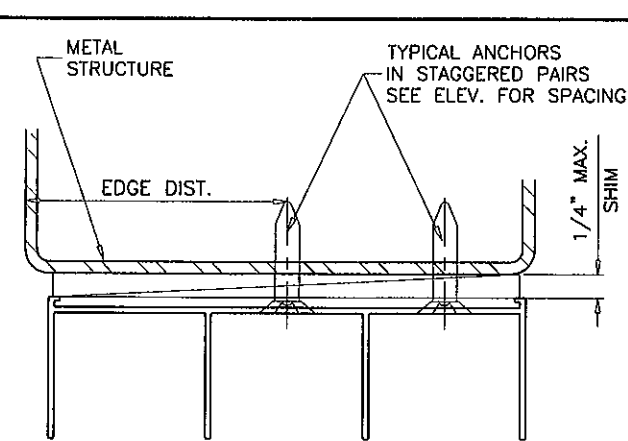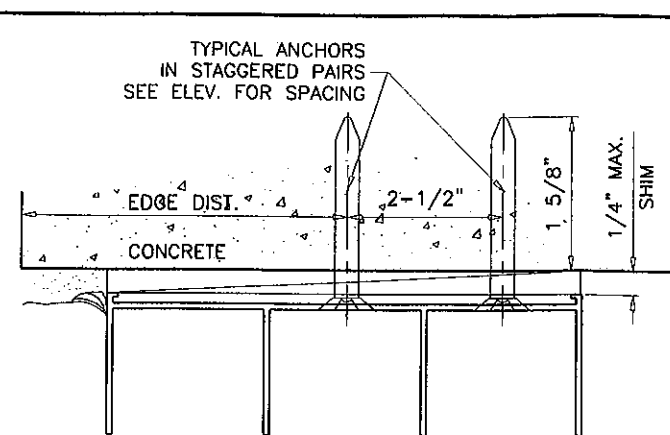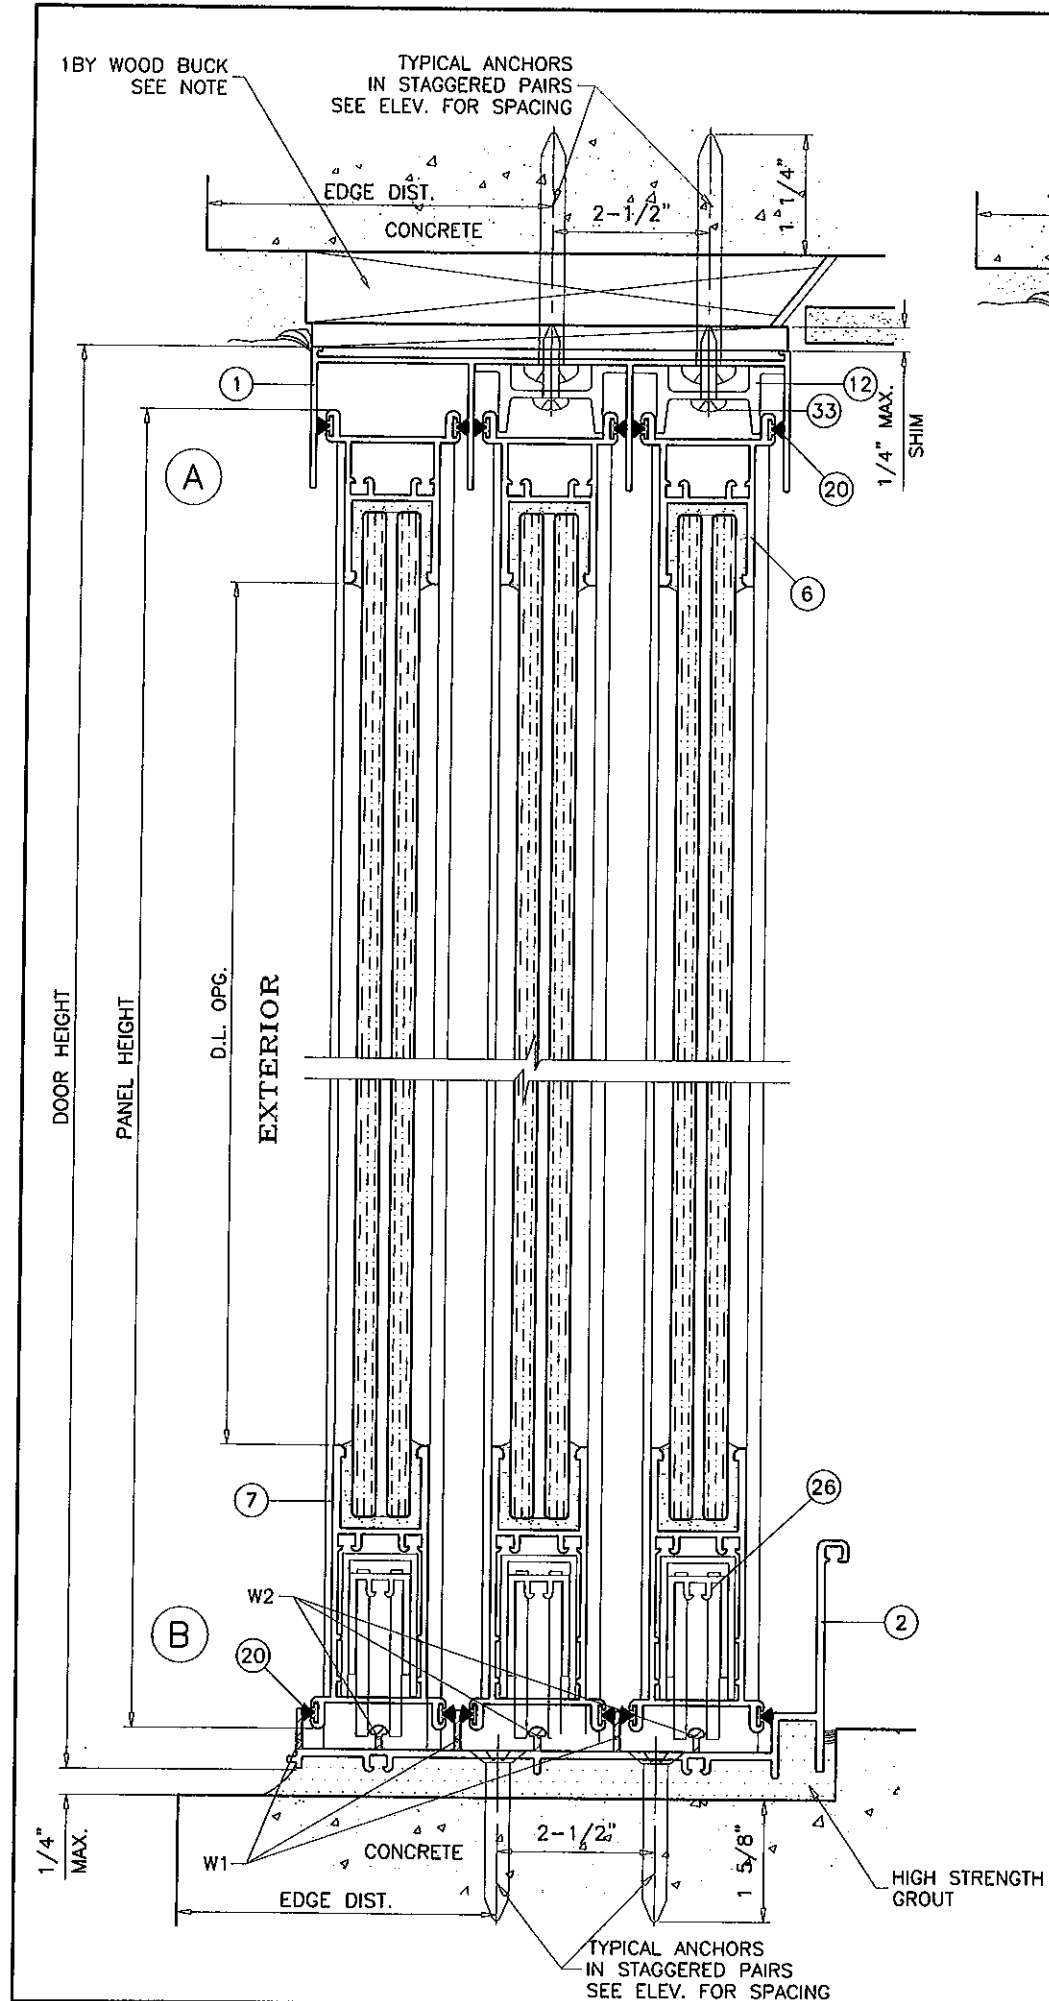

1BY OR 2BY WOOD BUCKS AND METAL STRUCTURE NOT BY TM WINDOWS
MUST SUSTAIN LOADS IMPOSED BY GLAZING SYSTEM
AND TRANSFER THEM TO THE BUILDING STRUCTURE.

TYPICAL ANCHORS: SEE ELEV. FOR SPACING

1/4" DIA. TAPCON BY 'ITW' (Fu=120 KSI, Fy=92 KSI)

1/4" DIA. ULTRACON BY 'ELCO' (Fu=177 KSI, Fy=155 KSI)

INTO 2BY WOOD BUCKS OR WOOD STRUCTURES

1-1/2" MIN. PENETRATION INTO WOOD

THRU 1BY BUCKS INTO CONC. OR MASONRY

1-1/4" MIN. EMBED INTO CONC. OR MASONRY

DIRECTLY INTO CONC. OR MASONRY

1-5/8" MIN. EMBED INTO CONC. OR MASONRY

1/4" TEKS OR SELF DRILLING SCREWS (GRADE 5 CRS)

INTO METAL STRUCTURES

STEEL : 12 GA. MIN. (Fy = 36 KSI MIN.)

ALUMINUM : 1/8" THK. MIN. (6063-T5 MIN.)

(STEEL IN CONTACT WITH ALUMINUM TO BE PLATED OR PAINTED)

#14 SMS OR SELF DRILLING SCREWS

INTO MIAMI-DADE COUNTY APPROVED MULLIONS (MIN. THK. = .100")
(NO SHIM SPACE)

TYPICAL EDGE DISTANCE

INTO CONCRETE AND MASONRY = 2-1/2" MIN.

INTO WOOD STRUCTURE = 1" MIN.

INTO METAL STRUCTURE = 3/4" MIN.

CONCRETE AT HEAD, SILL OR JAMBS f'c = 3000 PSI MIN.

C-90 HOLLOW/FILLED BLOCK AT JAMBS f'm = 2000 PSI MIN.

PRODUCT REVISED
as complying with the Florida
Building Code
Acceptance No 12-0403.03
Expiration Date 3/16/14
By Ishaq J. Chaudhry
Miami Dade Product Control

SEALANTS:

FRAME AND PANEL CORNERS AND INSTALLATION SCREWS
AT SILL AND JAMBS SEALED WITH JOINT SEALANT.

WEEPHOLES:

W1 = (6) 1" WEEP NOTCH AT EACH END OF SILL

W2 = (6) 1" WEEP NOTCH AT EACH END OF SILL

Engr: JAVAD AHMAD
CIVIL
FLA. PE # 70592
C.A.N. 3538

MAY 31 2012

af c
AL-FAROOQ CORPORATION
ENGINEERS & PRODUCT DEVELOPMENT
1235 S.W. 87 AVE
MIAMI, FLORIDA 33174
TEL (305) 264-8100 FAX (305) 262-6978
COMP-ANL\W03-90TMW

SERIES-370 ALUM. SLIDING GLASS DOOR (L.M.I.)
T.M. WINDOWS LLC.
601 N.W. 12TH AVE.
POMPANO BEACH, FL. 33069
TEL (954) 781-4430 FAX (954) 781-5078

no	date	by	description
A	01.27.04	REV. PER BCCO COMMENTS	
B	03.02.04	REV. PER BCCO COMMENTS	
C	10.12.05	NO CHANGE THIS SHEET	
D	03.06.09	UPDATED FOR 2007 FBC	
E	03.23.12	NO CHANGE THIS SHEET	

date: 10-06-03
scale: 1/2" = 1"
dr. by: HAMID
chk. by:

drawing no.
W03-90

sheet 3 of 7

POCKET CAVITY NOT BY TM WINDOW
NOT PART OF THIS NOA
TO BE REVIEWED BY AHJ

TYPICAL ANCHORS
AT 16" O.C.

ANCHORS EMBEDMENT INTO
CONCRETE = 1-5/8"
FILLED BLOCK = 1-1/4"
WOOD = 1-1/2"

TYPICAL ANCHORS
AT 13" O.C.

PANEL WIDTH

D.L. OPG.

EXTERIOR

DOOR WIDTH

PANEL WIDTH

D.L. OPG.

(3) #10 X 2"
SELF DRILLING SCREWS
AT 10" FROM EACH END
& ONE AT MIDSPAN

(2) #10 X 1" SMS
AT TOP & BOTTOM RAILS

1/4" MAX.
SHIM

CONCRETE
OR
MASONRY

TYPICAL ANCHORS
AT 13" O.C.
SEE ELEV.

EDGE DIST.

CONCRETE
OR
MASONRY

TYPICAL ANCHORS
AT 13" O.C.
SEE ELEV.

EDGE DIST.

EXTERIOR

DOOR WIDTH

Engr: JAVAD AHMAD
CIVIL
FLA. PE # 70592
C.A.N. 3538

MAY 31 2012

PRODUCT REVISIONS
on supplying with the Florida
Building Code
Amendment No. 12-0403.02
Expiration Date 3/18/14
By: *L. Shag I. Khan*
Miami Date Product Control

af c
AL-FAROOQ CORPORATION
ENGINEERS & PRODUCT DEVELOPMENT
1235 S.W. 87 AVE
MIAMI, FLORIDA 33174
TEL. (305) 264-8100 FAX. (305) 262-6978
COMP-ANL\W03-90TMW


SERIES-370 ALUM. SLIDING GLASS DOOR (L.M.I.)
T.M. WINDOWS LLC.
601 N.W. 12TH AVE.
POMPANO BEACH, FL. 33069
TEL. (954) 781-4430 FAX. (954) 781-5078

Revisions:				
no	date	by	description	
A	01.27.04	REV.	PER BCCO COMMENTS	
B	03.02.04	REV.	PER BCCO COMMENTS	
C	10.12.05	NO	CHANGE THIS SHEET	
D	03.06.09	UPDATED	FOR 2007 FBC	
E	03.23.12	NO	CHANGE THIS SHEET	

date: 10-06-03
scale: 1/2" = 1"
dr. by: HAMID
chk. by:


drawing no.
W03-90
sheet 4 of 7

EXTERIOR

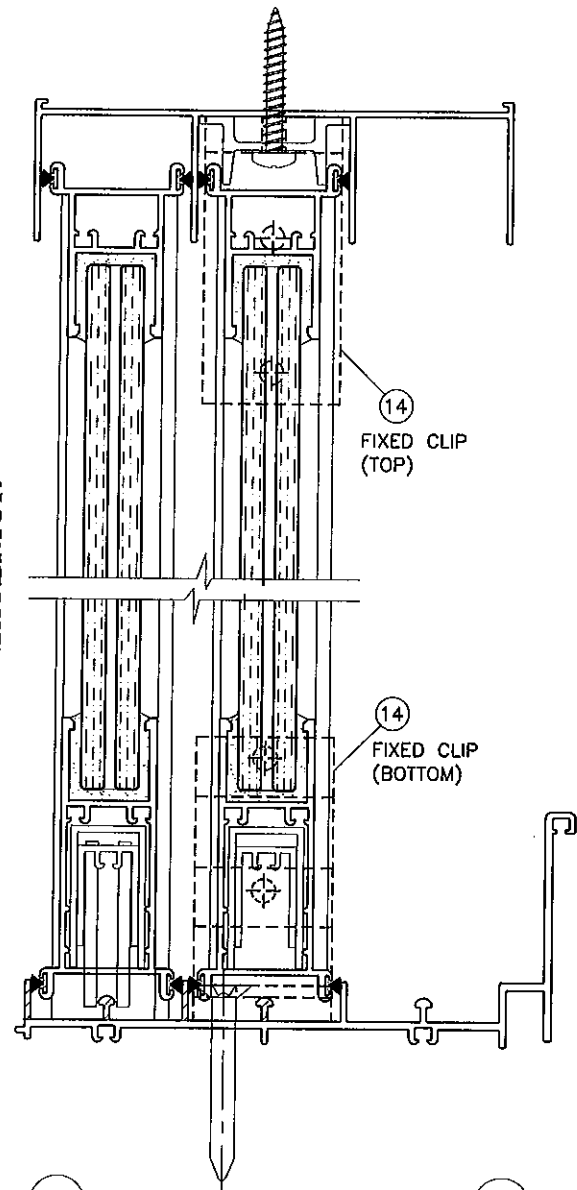

FIXED PANEL INSTALLATION DETAILS


SHOWN FOR ILLUSTRATION PURPOSE ONLY,
SEE APPLICABLE ANCHOR INSTALLATIONS IN SHEETS 3 & 4

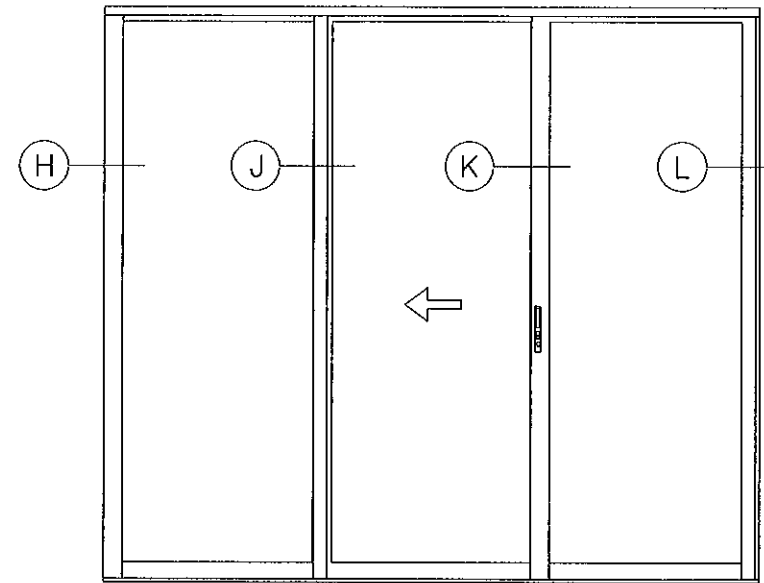

OXO
OR OXO REVERSE

1/4" TAPCONS
1-3/4" MIN. EMBED

#14 X 1-1/4" SMS

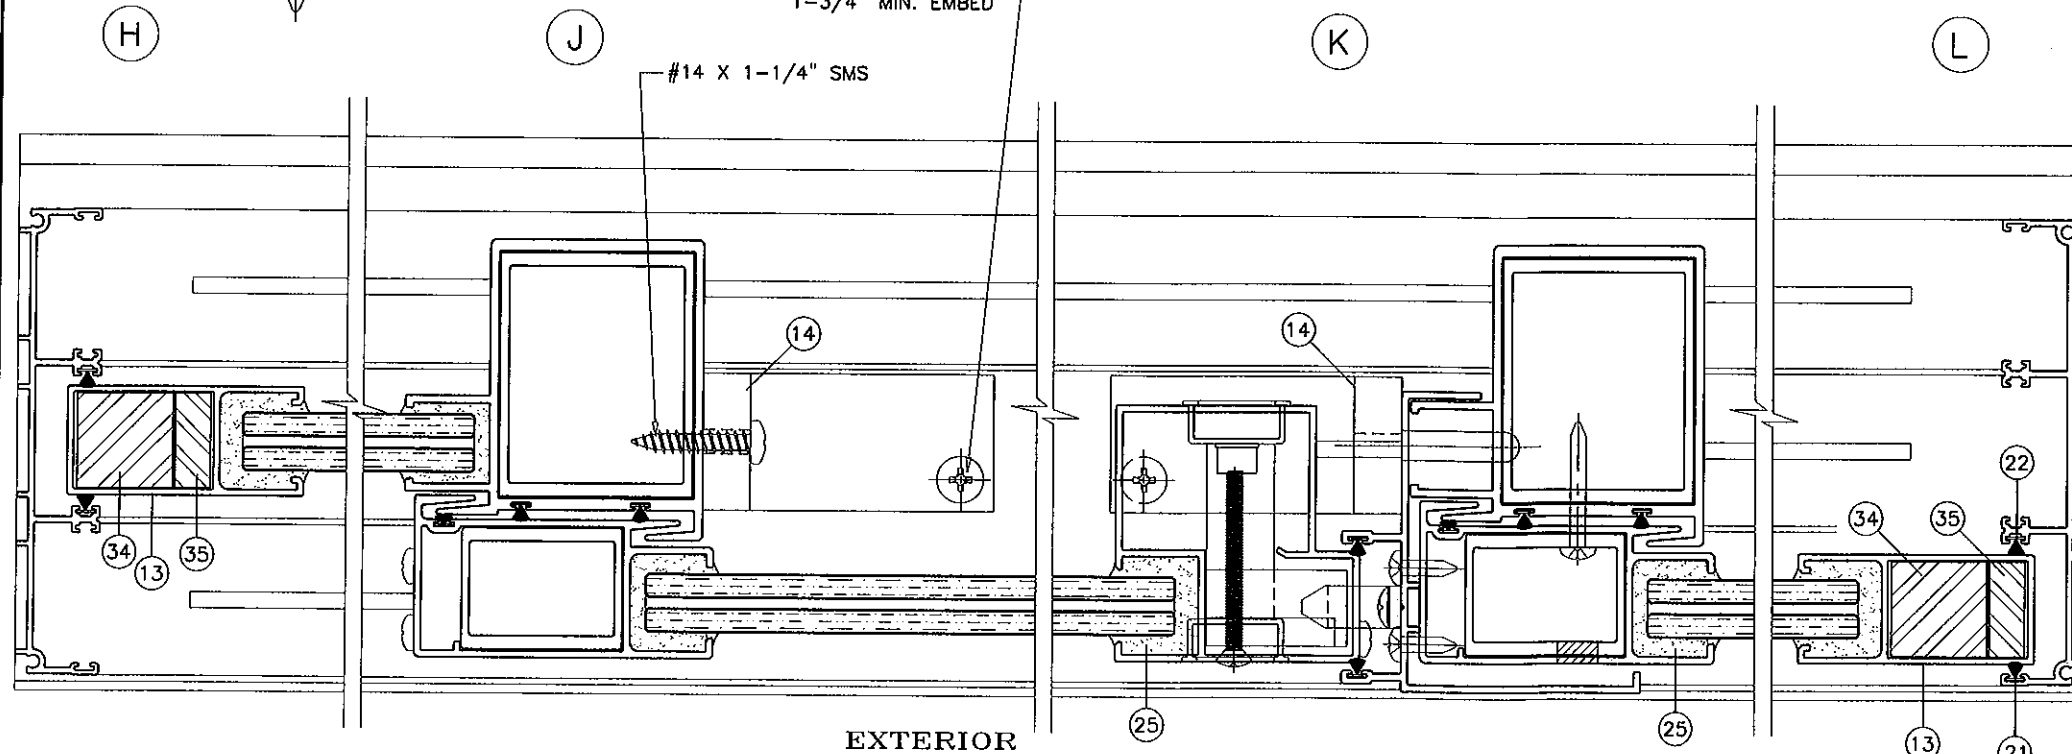

EXTERIOR

PRODUCT REVISED
as complying with the Florida
Building Code
Acceptance No. 12-0403-03
Expiration Date 3/18/14
By: Ismael L. Chaudhry
Ismael L. Chaudhry Product Control

Engr: JAVAD AHMAD
CIVIL
FLA. PE # 70592
C.A.N. 3538

MAY 31 2012

af c

AL-FAROOQ CORPORATION
ENGINEERS & PRODUCT DEVELOPMENT
1235 S.W. 87 AVE
MIAMI, FLORIDA 33174
TEL (305) 264-8100 FAX (305) 262-6978
COMP - ANL \ W03 - 90TMW

SERIES-370 ALUM. SLIDING GLASS DOOR (L.M.I.)

T.M. WINDOWS LLC.

601 N.W. 12TH AVE.
POMPANO BEACH, FL. 33069


TEL. (954) 781-4430 FAX. (954) 781-5078

revisions:		no	date	by	description
A	01.27.04	THIS SHEET ADDED			
B	03.02.04	REV. PER BCO COMMENTS			
C	10.12.05	NO CHANGE THIS SHEET			
D	03.06.09	UPDATED FOR 2007 FBC			
E	03.23.12	NO CHANGE THIS SHEET			


date: 10-06-03	scale: 1/2" = 1"	dr. by: HAMID	chk. by:
----------------	------------------	---------------	----------

drawing no.
W03-90


sheet 5 of 7

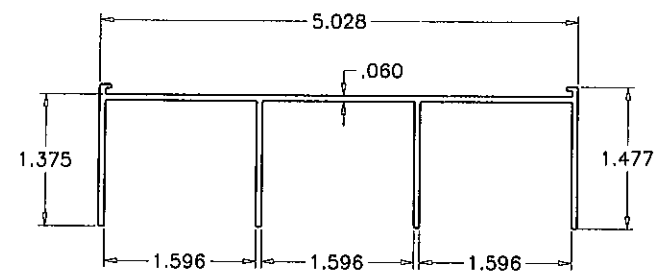


FRAME HEAD
SW-27509

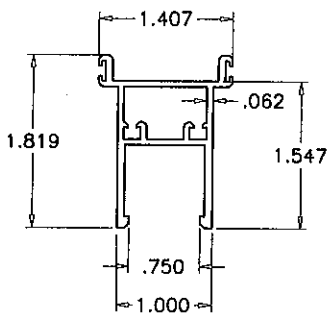


PANEL TOP RAIL
GW 37632

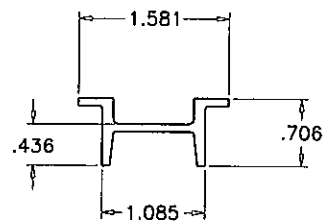


TOP CLIP
TM-110

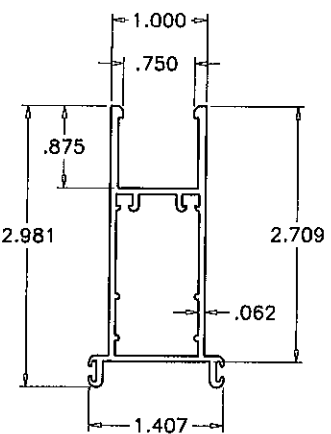


PANEL BOTTOM RAIL
GW 37624

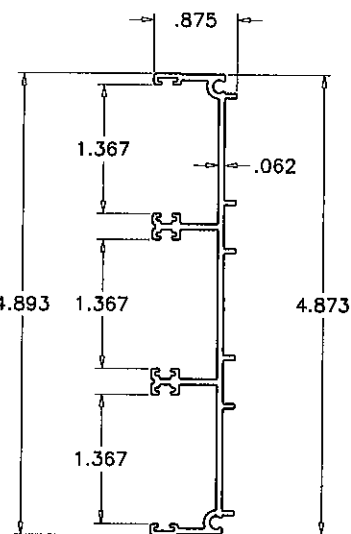


DOOR FRAME JAMB
GW-31172

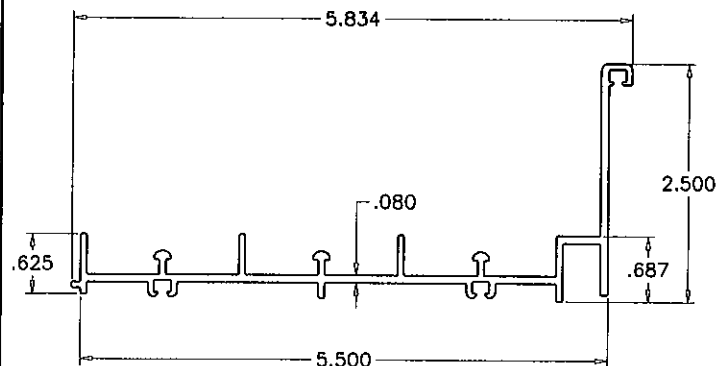


FRAME SILL
TM-111

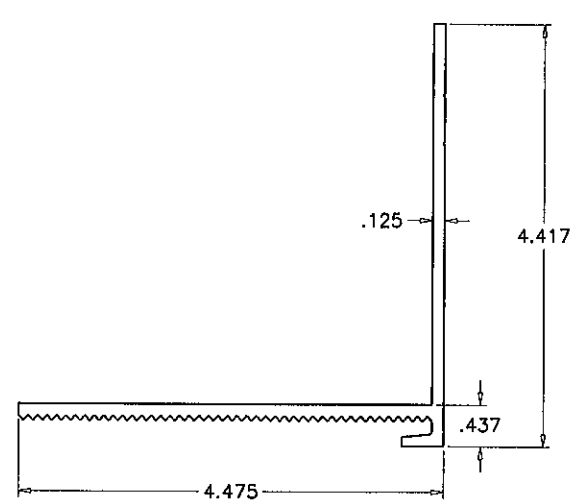


WALL ANGLE BRACKET
TM-104
LENGTH = PANEL HT.

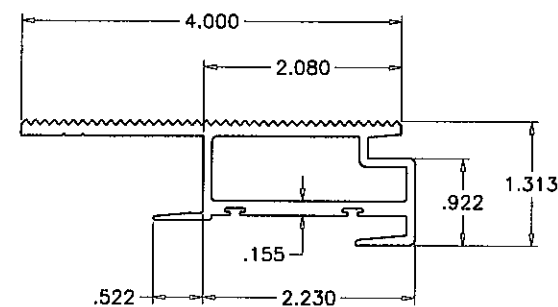


WALL INTERLOCK
TM-105

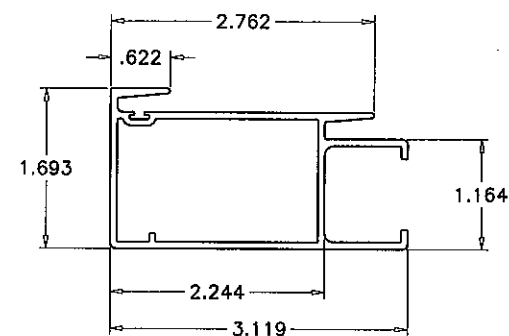


POCKET MINOR INTERLOCK
TM-106

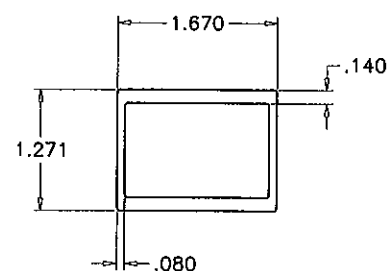


MINOR INTERLOCK REINFORCEMENT
TM-107
LENGTH = PANEL HT. - 4.5"

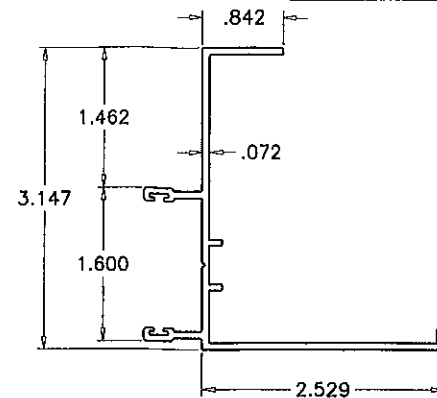


STILE ADAPTER
GW 37629

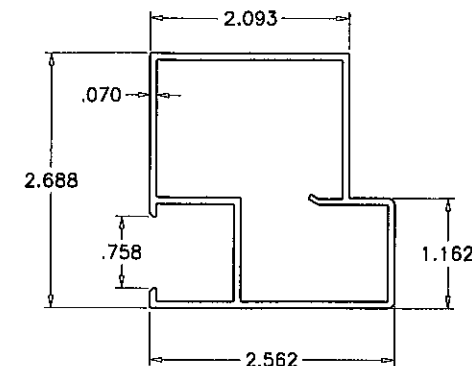


MALE BUTT STILE/LOCK STILE
GW 37623

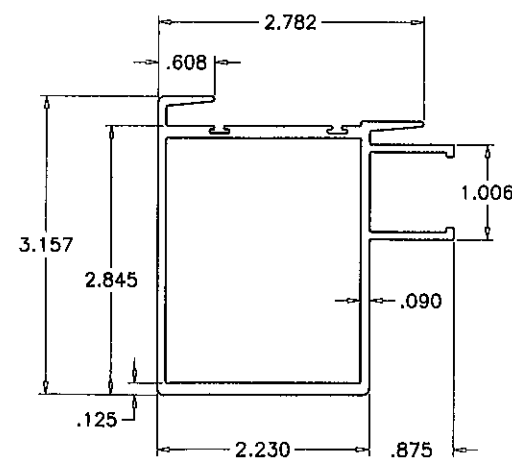


POCKET MAJOR INTERLOCK/ASTRAGAL
TM-108

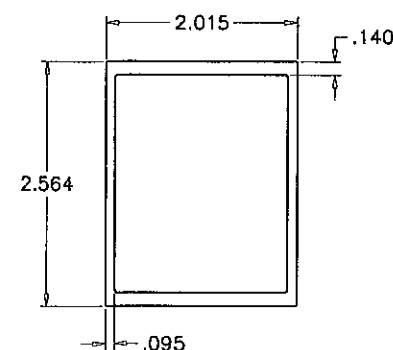


MAJOR INTERLOCK REINFORCEMENT
TM-109

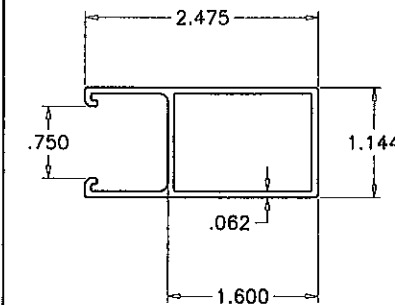


FIX. PANEL STILE
GW 37637

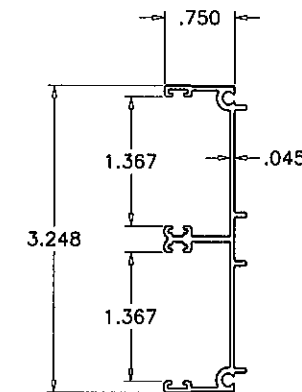

DOOR FRAME JAMB
GW 34977

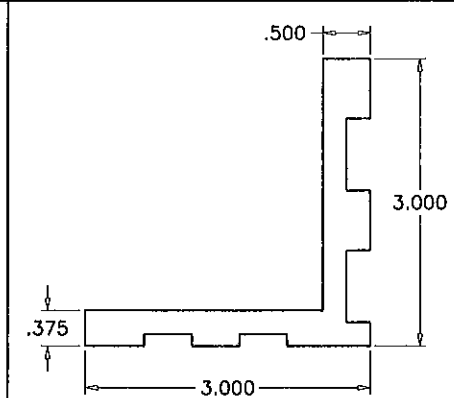

FIX. PANEL CLIP
GW 37743

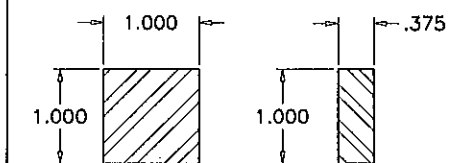

REINFORCING BARS

PRODUCT REVIEWED
in compliance with the Florida
Building Code
Acceptance No. 12-0403.03
Expiration Date 3/18/14
By: *Isaac J. Chaudhry*
Miami Dade Product Control

Engr: JAVAD AHMAD
CIVIL
FLA. PE # 70592
C.A.N. 3538
[Signature]
MAY 8 1 2012


af c
AL-FAROOQ CORPORATION
ENGINEERS & PRODUCT DEVELOPMENT
1235 S.W. 87 AVE
MIAMI, FLORIDA 33174
TEL. (305) 264-8100 FAX. (305) 262-6978
COMP-ANL W03-90TMM

SERIES-370 ALUM. SLIDING GLASS DOOR (L.M.I.)
T.M. WINDOWS LLC.
601 N.W. 12TH AVE.
POMPANO BEACH, FL. 33069
TEL. (954) 781-4430 FAX. (954) 781-5078


revisions:	no	date	by	description
	A	01.27.04	REV. PER BCCO COMMENTS	
	B	03.02.04	REV. PER BCCO COMMENTS	
	C	10.12.05	NO CHANGE THIS SHEET	
	D	03.06.09	UPDATED FOR 2007 FBC	
	E	03.23.12	NO CHANGE THIS SHEET	

date: 10-06-03
scale: 1/2" = 1"
dr. by: HAMID
chk. by:

drawing no.
W03-90
sheet 6 of 7

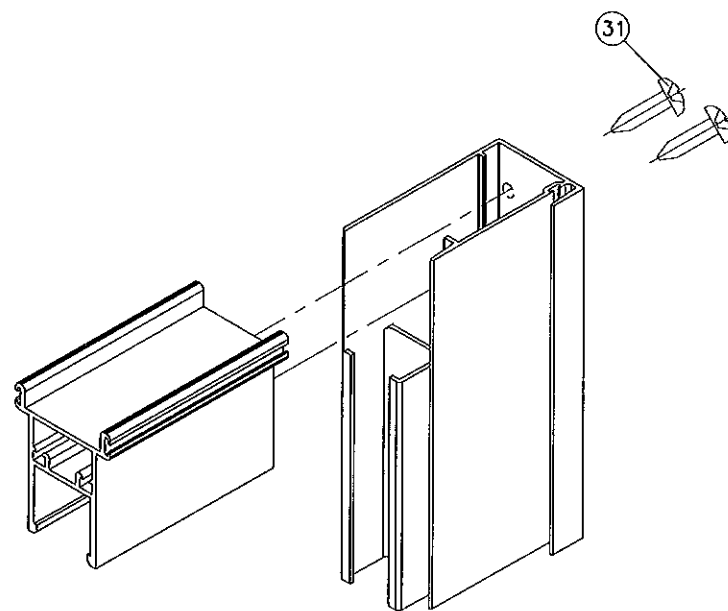

PANEL TOP CORNER

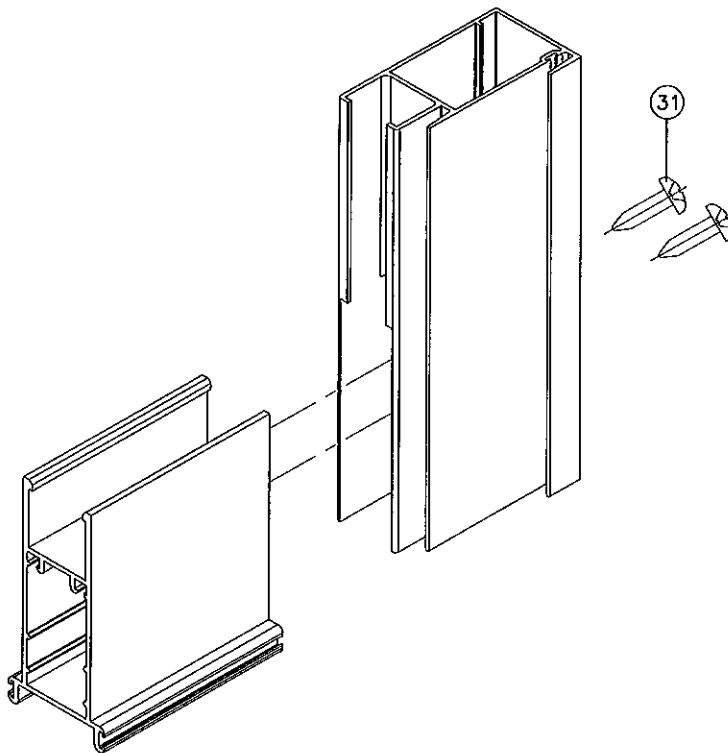

PANEL BOTTOM CORNER

ITEM No.	PART No.	QUANTITY	DESCRIPTION	MATERIAL	MANF./SUPPLIER/REMARKS
1	SW-27509	1	FRAME HEAD (3 TRACKS)	6063-T6	XXX
2	TM-111	1	FRAME SILL (3 TRACKS)	6063-T6	XXX
3	GW-31172	1	FRAME JAMB (3 TRACKS)	6063-T6	XXX
3A	GW 34977	1	FRAME JAMB (2 TRACKS)	6063-T6	XXX
4	TM-104	AS REQD.	WALL ANGLE BRACKET	6063-T6	XXX
5	TM-105	AS REQD.	WALL INTERLOCK	6063-T6	XXX
6	GW-37632	1/ PANEL	TOP RAIL	6063-T6	XXX
7	GW-37624	1/ PANEL	BOTTOM RAIL	6063-T6	XXX
8	TM-108	AS REQD.	POCKET MAJOR INTERLOCK	6063-T6	XXX
9	TM-106	AS REQD.	POCKET MINOR INTERLOCK	6063-T6	XXX
10	TM-107	1/ INTERLOCK	MINOR INTERLOCK REINFORCEMENT	6063-T6	FULL LENGTH
11	TM-109	1/ INTERLOCK	MAJOR INTERLOCK REINFORCEMENT	6063-T6	FULL LENGTH
12	TM-110	7	TOP CLIP, 9-1/2" LONG	6063-T6	1 EACH ABOVE ALL INTERLOCKING & FEMALE STILES
13	GW 37637	AS REQD.	FIXED PANEL STILE	6063-T6	XXX
14	GW 37743	AS REQD.	FIX. PANEL CLIP	ALUMINUM	XXX
15	GW-37623	AS REQD.	MALE BUTT STILE	6063-T6	PANEL LOCK SIDES
16	GW-37629	AS REQD.	STILE ADAPTER	6063-T6	PANEL ASTRAGAL
20	4020-PILE	1 ROW	"ULTRAFAB" FIN SEAL WEATHERSTRIP	WOOL	TOP & BOTTOM RAILS
21	4037-PILE	2 ROWS	"ULTRAFAB" FIN SEAL WEATHERSTRIP	WOOL	INTERIOR INTERLOCK STILES/FRAME JAMBS
22	4020-PILE	1 ROW	"ULTRAFAB" FIN SEAL WEATHERSTRIP	WOOL	FRAME JAMBS/ASTRAGAL
23	XXX	AS REQD.	3/4 x 2 1/2" LG. SELF-ADHESIVE FIN SEAL PAD	WOOL	XXX
24	XXX	AS REQ'D	POLYURETHANE SEALANT	FOAM	ENDS/INTERLOCKS
25	DOW 995	AS REQ'D	STRUCTURAL SILICONE	SILICONE	PANELS
26	TM-36205	2/ PANEL	TM TANDEM ROLLER ASSEMBLY	ALUM/NYLON	BOTTOM OF PANELS
27	TM-32476	2	TM LATCH ASSEMBLY	ALUM/VINYL	MALE ASTRAGAL
28	TM-32424	2	TM KEEPER	ALUMINUM	FEMALE ASTRAGAL
29	XXX	2/LATCH	#10 X 2" OH. MS. ASSEMBLY SCREW	STEEL	LATCH ASSY.
30	XXX	2/KEEPER	#10 x 1/2" TR. HD. KEEPER INST. SCREW	STEEL	FEMALE ASTRAGAL
31	XXX	8/PANEL	#10 x 1" PH. SMS. PANEL ASSY. SCREW	STEEL	PANEL CORNERS
33	XXX	2/CLIP	#10 x 1" PH. SMS. TOP CLIP INST. SCREW	STEEL	HEAD INTERLOCKS
34	XXX	AS REQD.	1" X 1" REINFORCING BAR	STEEL	AT FIX. PANEL STILE
35	XXX	AS REQD.	3/8" X 1" REINFORCING BAR	STEEL	AT FIX. PANEL STILE

PRODUCT REVISED
to comply with the Florida
Building Code
Assignment No. 12-0403-03
Expiration Date: MAR 18, 2014
by: *Chas. J. Hanks*
Robert Dade Product Council

Engr: JAVAD AHMAD
CIVIL
FLA. PE # 70592
C.A.N. 3538
[Signature]
MAY 31 2012

af c
AL-FAROOQ CORPORATION
ENGINEERS & PRODUCT DEVELOPMENT
1235 S.W. 87 AVE
MIAMI, FLORIDA 33174
TEL. (305) 262-6978 FAX. (305) 262-6978
COMP-ANL\W03-90TMW

SERIES-370 ALUM. SLIDING GLASS DOOR (L.M.I.)
T.M. WINDOWS, LLC.
601 N.W. 12TH AVE.
POMPANO BEACH, FL 33069
TEL. (954) 781-4430 FAX: (954) 781-5078

no	date	by	description
A	01.27.04	REV. PER BCCO COMMENTS	
B	03.02.04	REV. PER BCCO COMMENTS	
C	10.12.05	NO CHANGE THIS SHEET	
D	03.06.09	UPDATED FOR 2007 FBC	
E	03.23.12	NO CHANGE THIS SHEET	

date: 10-06-03
scale: 1/2" = 1"
dr. by: HAMID
chk. by:

drawing no.
W03-90
sheet 7 of 7